


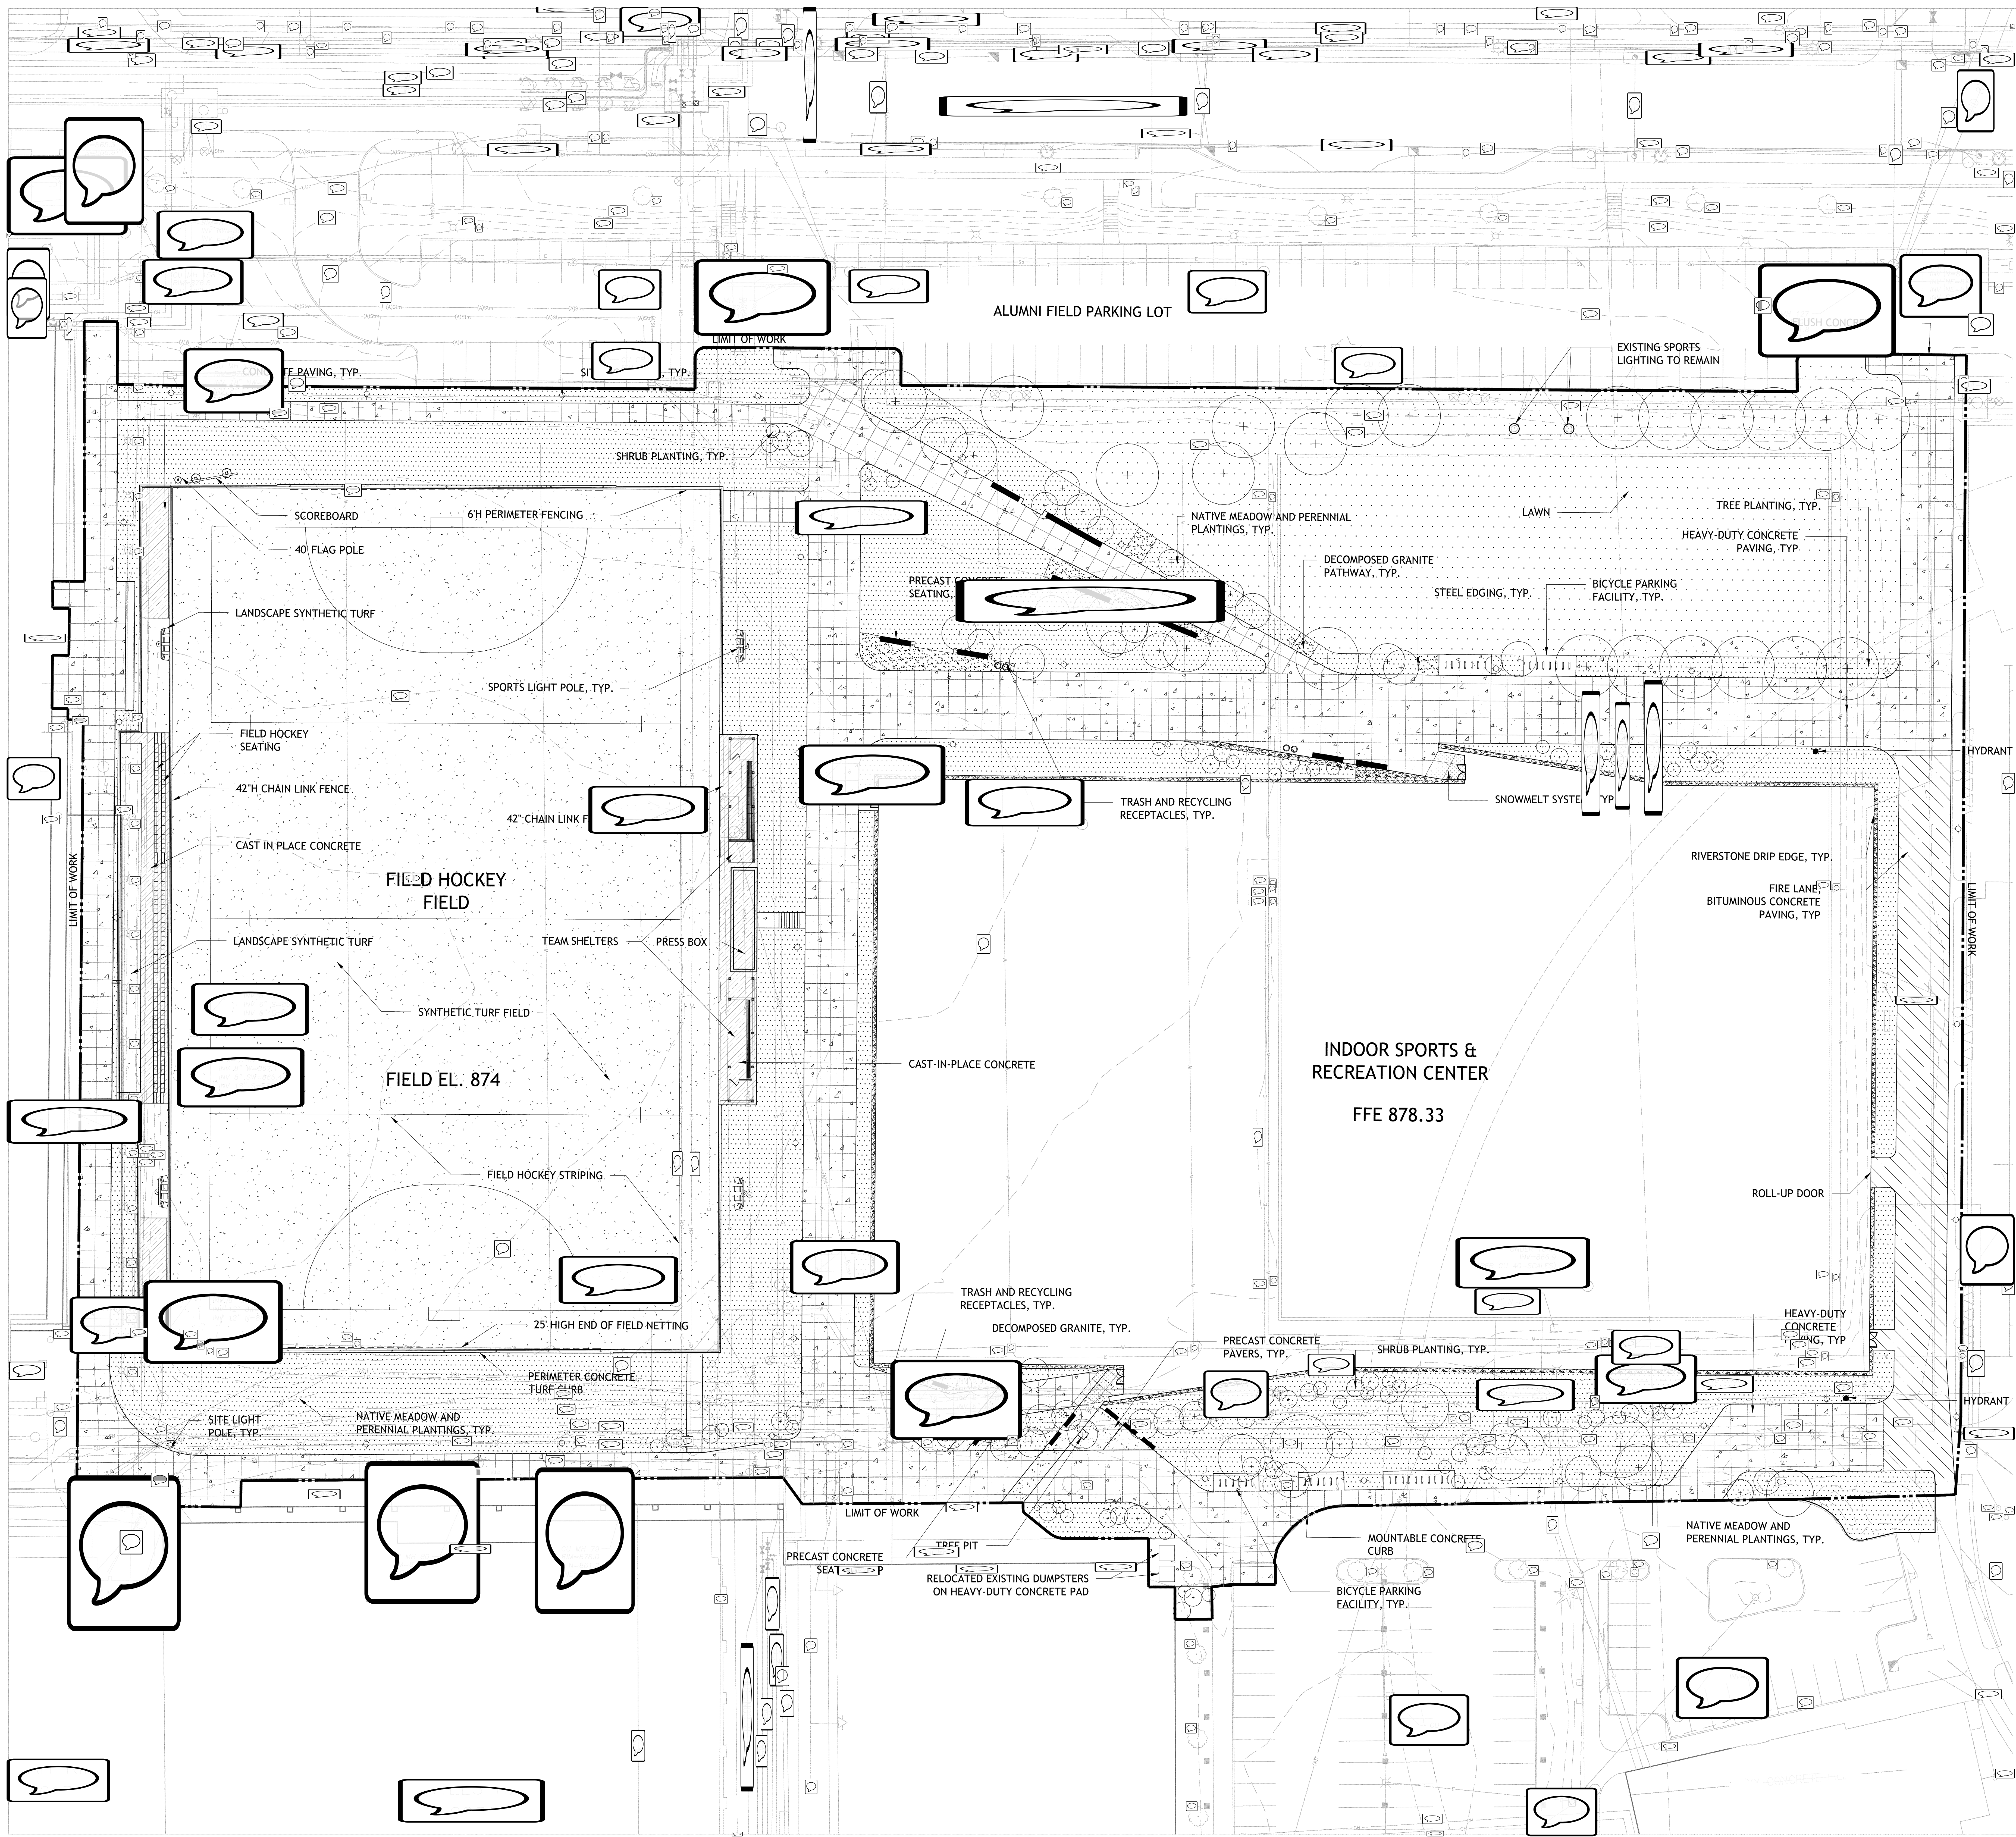

LEGEND

SYMBOLS	DESCRIPTION
	BITUMINOUS CONCRETE PAVING
	HEAVY-DUTY CONCRETE PAVING
	CONCRETE PAVING
	PRECAST CONCRETE PAVERS
	DECOMPOSED GRANITE
	SYNTHETIC TURF
	LAWN
	NATIVE MEADOW AND PERENNIAL PLANTINGS
	SNOWMELT SYSTEM
	DECIDUOUS TREE PLANTINGS
	SHRUB PLANTINGS

MATERIALS NOTES:

1. TYPES OF MATERIALS AND FINISHES ARE NOTED IN THE LEGEND.

2. ALL LANDSCAPE MATERIALS AND LAYOUT SHALL BE COORDINATED WITH CIVIL DRAWINGS AND ARCHITECTURE CONSTRUCTION PACKAGES

SASAKI

110 CHAUNCEY STREET BOSTON, MA 02111 USA
P: 617.926.8300 F: 617.926.8748 W: SASAKI.COM

ARCHITECT + LANDSCAPE ARCHITECT

SASAKI

110 Chauncey Street
Boston, MA 02111
TEL. 617.926.3300
www.sasaki.com

CIVIL

TG MILLER

605 West State Street, Suite A
Ithaca, NY 14850
TEL. 607.272.6477
www.tgmillerpc.com

STRUCTURAL

LEMESSURIER

1380 Soldiers Field Road
Boston, MA 02135
TEL. 617.868.1200
www.lemessurier.com

MEP/FP

RFS ENGINEERING

71 Water Street
Laconia, NH 03246
TEL. 603.524.4647
www.rfsengineering.com

BUILDING AND FIRE CODE

HOWE ENGINEERS

141 Longwater Drive, Suite 110
Norwell, MA 02061
TEL. 781.878.3500
www.howeengineers.com

NOT FOR CONSTRUCTION

1	SITE PLAN REVIEW- PRE APPLICATION	20 OCT 2023
No.	Description	Date
DWG ISSUE & REVISION HISTORY		
Stamp		

Key Plan

North

Project Title:

Cornell University

Indoor Sports and Recreation
Center & Field Hockey

Tower Road
Ithaca, NY 14853

Drawing Title:

MATERIALS
PLAN

Project No: 28020.00U Scale: 1"=20'

Drawn By: JSP

Checked By: TS

Approved By: AG

Date: 12/01/2023

Drawing No.

L3-01